

INSPECTOR'S DAILY REPORT
CEMETERY RELOCATIONS

PROJECT

NORTH FORK LAKE

DATE

17 Oct 1974

CONTRACT NO.

DACW 63-75-C-0034

CONTRACTOR

PHILLIP I. ELLEN

ORDFR NO.	NAME	APPROXIMATE DATE OF DEATH	REMOVED FROM		REMAINS FOUND (Yes - No)*	REINTERRED	
			CEMETERY	GRAVE NUMBER		CEMETERY	GRAVE NUMBER
1	W. J. KEATING	MAR 30, 1870	KEATING	101	YES	ANDICE	101
2	UNKNOWN	UNKNOWN	KEATING	111	YES	ANDICE	111
3	UNKNOWN	UNKNOWN	KEATING	112	YES	ANDICE	112
4	UNKNOWN	UNKNOWN	KEATING	113	YES	ANDICE	113
5	TOM P. HANKS	APR 26, 1889	KEATING	100	YES	ANDICE	100
6	UNKNOWN	UNKNOWN	KEATING	114	YES	ANDICE	114
7	UNKNOWN	UNKNOWN	KEATING	115	YES	ANDICE	115
8	UNKNOWN	UNKNOWN	KEATING	102	YES	ANDICE	102
9	UNKNOWN	UNKNOWN	KEATING	103	YES	ANDICE	103
* SEE REVERSE SIDE							

FOREMAN

INSPECTOR

Robert E. Beyer

- 101 BONE FRAGMENTS, SMALL BONES, LARGE BONES. THIS GRAVE APPEARED TO HAVE BEEN DUG UP BY VANDALS. GRAVE DUG BY: GEORGE LOCKLEAR TIME: 0900 TO 0920
- 111 SOME BONE FRAGMENTS, ROTTEN WOOD, ARROWHEAD, DISCOLORED DIRT. DUG BY MALK JONES
TIME: 0900 to 1015
- 112 BONES, NAILS, ROTTEN WOOD DISINTERRED BY: GARY STRICKLAND TIME 0900 TO 1020
- 113 FULL SKELETON - DISINTERRED BY: JASON LOCKLEAR ~~8~~ TIME: 0900 TO 1020
- 100 ONE LEG BONE, SMALL BONES - GRAVE APPEARED TO HAVE BEEN ~~ME~~ DUG UP BY VANDALS
DISINTERRED BY: GEORGE LOCKLEAR TIME: 0920 TO 0935
- 114 THIS GRAVE FOUND BY PROBING. FOUND: COMPLETE SKELETON, ROTTEN WOOD, PLATE GLASS.
DISINTERRED BY: GARRY STRICKLAND TIME: 0925 TO 1220
- 115 GRAVE FOUND BY PROBING. FOUND: SMALL BONES, COULD HAVE BEEN AN INFANT
DISINTERRED BY: GEORGE LOCKLEAR TIME: 0925 TO 1130
- 102 MOST OF COMPLETE SKELETON, ROTTEN WOOD. DISINTERRED BY: JASON LOCKLEAR
TIME: 0925 TO 1140
- 103 COMPLETE SKELETON, HAIR COMB DISINTERRED BY: MALK JONES TIMES 0925 TO 1420

INSPECTOR'S DAILY REPORT

CEMETERY RELOCATIONS

PROJECT

NORTH FORK LAKE

DATE

17 Oct 1974

CONTRACT NO.

DACW63-75-C-0034

CONTRACTOR

PHILLIP I. ELLEN

ORDFR NO.	NAME	APPROXIMATE DATE OF DEATH	REMOVED FROM		REMAINS FOUND (Yes - No) *	REINTERRED	
			CEMETERY	GRAVE NUMBER		CEMETERY	GRAVE NUMBER
10	UNKNOWN	UNKNOWN	KEATING	105	YES	ANDICE	105
11	UNKNOWN	UNKNOWN	KEATING	106	YES	ANDICE	106
12	UNKNOWN	UNKNOWN	KEATING	116	YES	ANDICE	116
13	UNKNOWN	UNKNOWN	KEATING	104	YES	ANDICE	104
14	UNKNOWN	UNKNOWN	KEATING	118	YES	ANDICE	118
15	UNKNOWN	UNKNOWN	KEATING	117	YES	ANDICE	117
16	UNKNOWN	UNKNOWN	KEATING	107	YES	ANDICE	107
17							
	SEE REVERSE SIDE						

FOREMAN

INSPECTOR

Robert E. Beggs

- 105 COMPLETE SKELETON, GLASS DISINTERRED BY: GEORGE LOCKLEAR TIME 1210 TO 1435
- 106 MOST OF FULL SKELETON, 4 CASKET HANDLES, ROTTEN CEDAR CASKET
DISINTERRED BY: JASON LOCKLEAR TIME: 1215 TO 1445
- 116 GRAVE FOUND BY PROBING. COMPLETE SKELETON OF SMALL CHILD
DISINTERRED BY: GARRY STRICKLAND TIME: 1225 TO 1450
- 104 VERY SMALL CHILD SKELETON, 3 BUTTONS, ROTTEN WOOD. DISINTERRED BY MACK JONES
TIME: 1425 TO 1645
- 118 GRAVE FOUND BY PROBING. BONE FRAGMENTS, WOOD, APPEARED TO BE A SMALL CHILD.
DISINTERRED BY: GEORGE LOCKLEAR TIME: 1445 TO 1540
- 117 GRAVE FOUND BY PROBING. FOUND CHILD SKELETON, SCREWS. DISINTERRED BY: JASON LOCKLEAR
TIME: 1453 TO 1615
- 107 BONES OF SMALL CHILD, ROTTEN WOOD, DISCOLORED EARTH. DISINTERRED BY: GARRY STRICKLAND
TIME: 1455 TO 1610


INSPECTOR'S DAILY REPORT CEMETERY RELOCATIONS			PROJECT	DATE			
			NORTH FORK LAKE	13 Oct 1974			
			CONTRACT NO.	CONTRACTOR			
			DACW63-75-C-0034	PHILLIP J. ELLEN			
ORDER NO.	NAME	APPROXIMATE DATE OF DEATH	REMOVED FROM		REMAINS FOUND	REINTERRED	
			CEMETERY	GRAVE NUMBER	(Yes - No) * #	CEMETERY	GRAVE NUMBER
17	UNKNOWN	UNKNOWN	KEATING	108	YES	ANDICE	108
18	UNKNOWN	UNKNOWN	KEATING	109	YES	ANDICE	109
19	UNKNOWN	UNKNOWN	KEATING	110	YES	ANDICE	110
* SEE REVERSE SIDE							
FOREMAN				INSPECTOR			

Robert E. Beggs

- 108 BABY SKELETON, ROTTEN CEDAR BOX, NAILS DISINTERRED BY: GARRY STRICKLAND TIME 0730
0810
- 109 FULL SKELETON OF SMALL CHILD, ROTTEN CEDAR BOX, HANDLES OF CASKET, NAILS
DISINTERRED BY: JASON LOCKLEAR TIME: 0730 TO 0820
- 110 BABY BONES DISINTERRED BY: GEORGE LOCKLEAR TIME: 0730 TO 0810



Grave Identification and Reinterment Schedule

Grave No.	Name of Deceased	Race	Dates of Birth and Death	Type of Monument	New Marker Req'd	Name and Address of Next-of-Kin	Relationship to Deceased	Permit Signed	To Be Present
100	Tom P. Hanks	W	B - 12 Dec 1859 D - 26 Apr 1889	Headstone and Footstone	No	Bernice (Mrs. B.W.) Armistead, Box 391, 714 East 11th Street Littlefield, Tex 79339	Granddaughter	Yes	No
101	W. J. Keating	W	B - 20 Aug 1828 D - 30 Mar 1870	Headstone	No	Unknown	Unknown	No	"
102	Unknown	W	Unknown	Native Stone (Unmarked)	Yes	Unknown	Unknown	"	"
103	Unknown	W	"	"	"	"	"	"	"
104	Unknown	W	"	"	"	"	"	"	"
105	Unknown	W	"	None	"	"	"	"	"
106	Unknown	W	"	"	"	"	"	"	"
107	Unknown	W	"	"	"	"	"	"	"
108	Unknown	W	"	"	"	"	"	"	"
109	Unknown	W	"	"	"	"	"	"	"
110	Unknown	W	"	"	"	"	"	"	"
111	Unknown	W	"	"	"	"	"	"	"
112	Unknown	W	"	"	"	"	"	"	"
113	Unknown	W	"	"	"	"	"	"	"
114	UNKNOWN		"	"	"	"	"	"	"
115	UNKNOWN		"	"	"	"	"	"	"
116	UNKNOWN		"	"	20	"	"	"	"
117	UNKNOWN		"	"	"	"	"	"	"
118	UNKNOWN		"	"	"	"	"	"	"

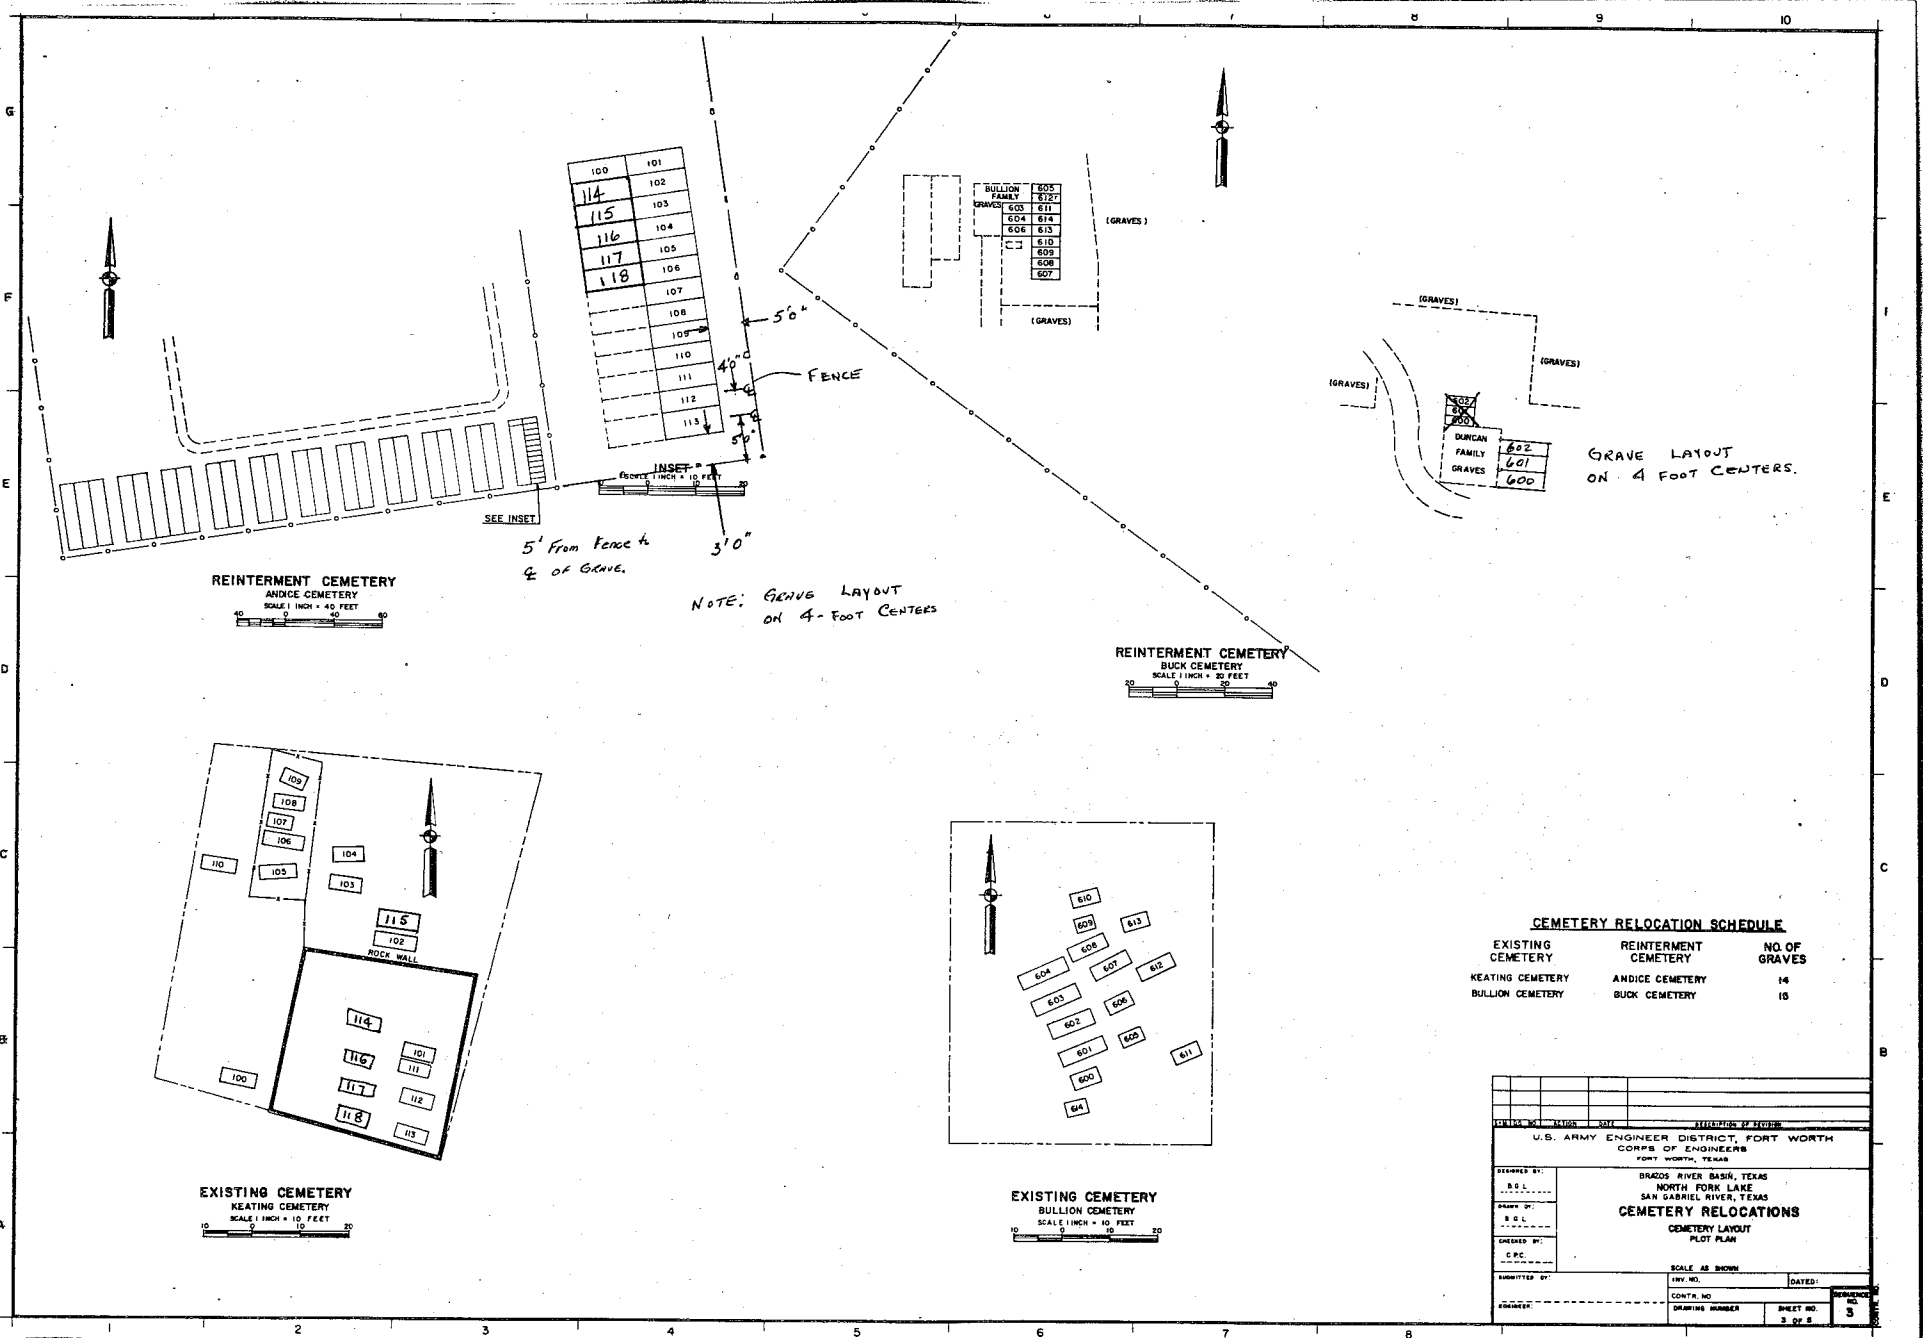

REINTERMENT CEMETERY
ANDICE CEMETERY
SCALE 1 INCH = 40 FEET

REINTERMENT CEMETERY
BUCK CEMETERY
SCALE 1 INCH = 20 FEET

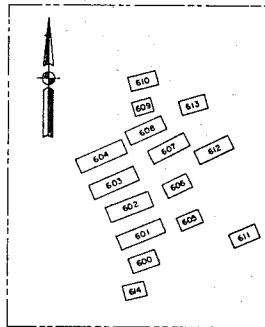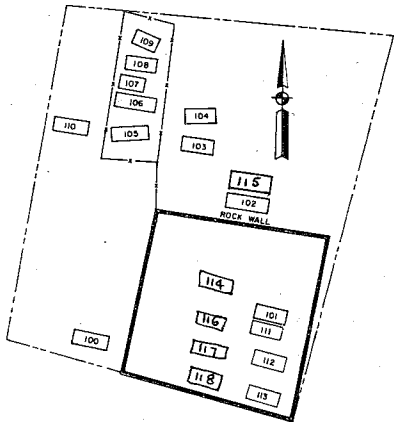

CEMETERY RELOCATION SCHEDULE

EXISTING CEMETERY	REINTERMENT CEMETERY	NO. OF GRAVES
KEATING CEMETERY	ANDICE CEMETERY	14
BULLION CEMETERY	BUCK CEMETERY	16

DRAWN BY: []		CHECKED BY: []	
U.S. ARMY ENGINEER DISTRICT, FORT WORTH CORPS OF ENGINEERS FORT WORTH, TEXAS			
DRAWN BY: B.S.L.		BRADYS RIVER BASIN, TEXAS	
DRAWN BY: B.S.L.		NORTH FORK LAKE	
DRAWN BY: B.S.L.		SAN GABRIEL RIVER, TEXAS	
CEMETERY RELOCATIONS			
CEMETERY RELOCATIONS PLOT PLAN			
CHECKED BY: C.P.C.		SCALE AS SHOWN	
SUBMITTED BY: []		ENV. NO. []	DATED: []
ENGINEER: []		CONTR. NO. []	PROJ. NO. []
DRAWING NUMBER []		SHEET NO. []	TOTAL SHEETS []
		3 OF 5	3